

RE DRAWN.

The SuDS Enviro data sheets, 2021 to 2026. What they were, what they are now, and the sheet that now draws itself.




FOUR EDITIONS OF ONE SHEET

SAME PRODUCTS. A NEW DRAWING OFFICE.

Dates and software from each file's own metadata.

2021 to 2023

SUPPLIED

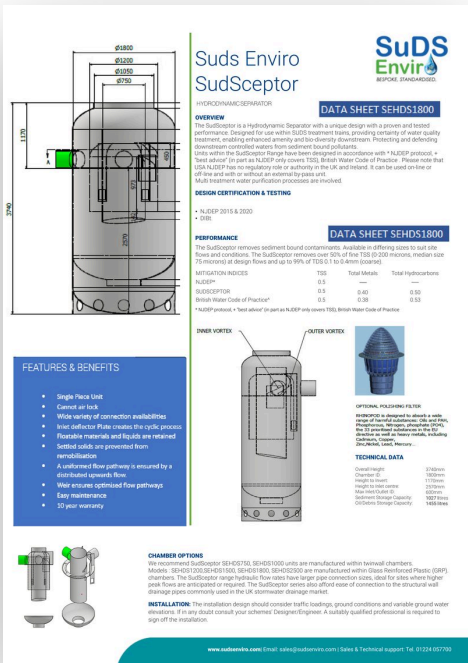

Drawing packs from AutoCAD 2017 and Inventor 2023. Data sheets assembled in Adobe Express, Nov 2023.

Bitmap drawings, pasted title bars

2025

FIRST PASS




Rebuilt in Illustrator, June and July 2025, on one template with the RHINO lockup.

One masthead, typeset tables

2026

REDRAWN

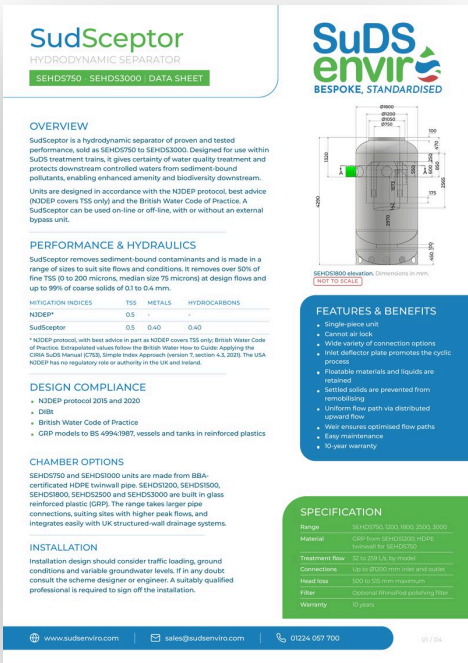


14 sheets written as web pages that print to A4. Every drawing redrawn in vector from the drawing packs.

Vector drawings, one system

2026+

GENERATED

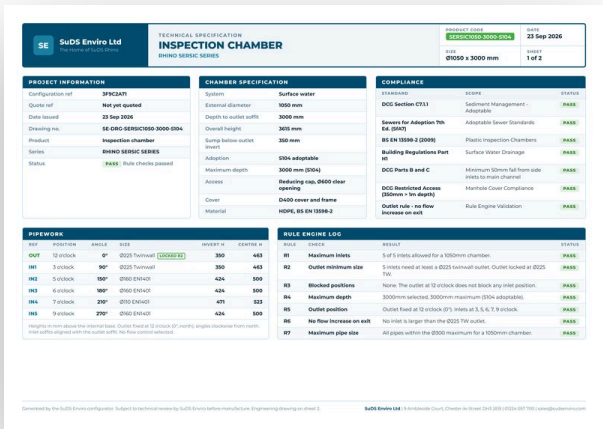

The configurator writes a project sheet from the customer's own choices, checked against the rules.

Drawn to order

THREE SHEETS. ONE SEPARATOR.

2023

SUPPLIED

2025

FIRST PASS

2026

REDRAWN

Suds Enviro SudSceptor

HYDRODYNAMIC SEPARATOR

DATA SHEET SEHDS1800

OVERVIEW

The SudSceptor is a Hydrodynamic Separator with a unique design with a proven and tested performance. Designed for use within SuDS treatment trains, providing certainty of water quality treatment, enabling enhanced amenity and bio-diversity downstream. Protecting and defending downstream controlled waters from sediment bound pollutants.

Units within the SudSceptor Range have been designed in accordance with * NJDEP protocol, + "best advice" (in part as NJDEP only covers TSS), British Water Code of Practice. Please note that USA NJDEP has no regulatory role or authority in the UK and Ireland. It can be used on-line or off-line and with or without an external by-pass unit.

Multi treatment water purification processes are involved.

DESIGN CERTIFICATION & TESTING

- NJDEP 2015 & 2020
- DIBt

PERFORMANCE

The SudSceptor removes sediment bound contaminants. Available in differing sizes to suit site flows and conditions. The SudSceptor removes over 50% of fine TSS (0-200 microns, median size 75 microns) at design flows and up to 99% of TDS 0.1 to 0.4mm (coarse).

MITIGATION INDICES	TSS	Total Metals	Total Hydrocarbons
NJDEP*	0.5	---	---
SUDSCEPTOR	0.5	0.40	0.50
British Water Code of Practice*	0.5	0.38	0.53

* NJDEP protocol, + "best advice" (in part as NJDEP only covers TSS), British Water Code of Practice

FEATURES & BENEFITS

- Single Piece Unit
- Cannot air lock
- Wide variety of connection availabilities
- Inlet deflector Plate creates the cyclic process
- Floatable materials and liquids are retained
- Settled solids are prevented from remobilisation
- A uniform flow pathway is ensured by a distributed upwards flow.
- Weir ensures optimised flow pathways
- Easy maintenance
- 10 year warranty

CHAMBER OPTIONS

We recommend SudSceptor SEHDS750, SEHDS1000 units are manufactured within twinwall chambers. Models: SEHDS1200, SEHDS1800, SEHDS2500 are manufactured within Glass Reinforced Plastic (GRP) chambers. The SudSceptor range hydraulic flow rates have larger pipe connection sizes, ideal for sites where higher peak flows are anticipated or required. The SudSceptor series also afford ease of connection to the structural wall drainage pipes commonly used in the UK stormwater drainage market.

INSTALLATION: The installation design should consider traffic loadings, ground conditions and variable ground water elevations. If in any doubt consult your schemes' Designer/Engineer. A suitably qualified professional is required to sign off the installation.

www.sudsenvirono.com | Email: sales@sudsenvirono.com | Sales & Technical support: Tel: 01224 057700

OPTIONAL POLISHING FILTER

RHINOPOD is designed to absorb a wide range of harmful substances: Oils and PAHs, Phosphorous, Nitrogen, phosphate (PO₄), the 33 prioritised substances in the EU directive as well as heavy metals, including Cadmium, Copper, Zinc, Nickel, Lead, Mercury...

TECHNICAL DATA

Overall Height:	3740mm
Chamber ID:	1800mm
Height to Invert:	1170mm
Height to inlet centre:	2570mm
Max Inlet/Outlet ID:	600mm
Sediment Storage Capacity:	1027 litres
Oil/Debris Storage Capacity:	1462 litres

SudSceptor

HYDRO-DYNAMIC SEPARATOR

SEHDS1800 | DATA SHEET

OVERVIEW

The SudSceptor is a Hydrodynamic Separator with a unique design with a proven and tested Performance. Designed for use within SuDS treatment trains, providing certainty of water quality treatment, enabling enhanced amenity and bio-diversity downstream. Protecting and defending downstream controlled waters from sediment bound pollutants.

Units within the SudSceptor Range have been designed in accordance with * NJDEP protocol, + "best advice" (in part as NJDEP only covers TSS), British Water Code of Practice.

Please note that USA NJDEP has no regulatory role or authority in the UK and Ireland. It can be used on-line or off-line and with or without an external by-pass unit.

Multi treatment water purification processes are involved.

DESIGN COMPLIANCE

- NJDEP 2015 & 2020
- DIBt

PERFORMANCE & HYDRAULICS

The SudSceptor removes sediment bound contaminants. Available in differing sizes to suit site flows and conditions. The SudSceptor removes over 50% of fine TSS (0-200 microns, median size 75 microns) at design flows and up to 99% of TDS 0.1 to 0.4mm (coarse).

MITIGATION INDICES	TSS	METALS	HYDROCARBONS
NJDEP*	0.5	---	---
SUDSCEPTOR	0.5	0.40	0.40

* NJDEP protocol, + "best advice" (in part as NJDEP Only covers TSS), British Water Code of Practice

DIMENSIONAL & STORAGE DATA

- Treatment Flow Rate : 73 L/s
- Hydraulic Capacity Flow : 222 L/s
- Max Head Loss: 500mm

DIMENSIONAL & STORAGE DATA

- Overall Height: 4290 mm
- Chamber Diameter: 1800 mm
- Height to Invert Inlet: 1320 mm
- Base Height to Invert Outlet: 2970 mm
- Max Inlet/Outlet Diameter: 600 mm
- Sediment Storage Capacity: 1027 litres
- Oil/Debris Storage Capacity: 1462 litres

Extrapolated values are based on the guidelines outlined in the British Water 'How to Guide: Applying the CIRIA The SuDS Manual (C753)' utilizing the Simple Index Approach (Version 7, Section 4.3, 2021 - pre-publication)."

CHAMBER OPTIONS:

SudSceptor SEHDS750 and SEHDS1000 units are manufactured from BBA CERTIFICATED HIGH DENSITY POLYETHYLENE TWINWALL PIPE. Models SEHDS1200, SEHDS1800, SEHDS2500 & SEHDS3000 are built using Glass Reinforced Plastic (GRP) and comply fully with BS 4994:1987 - Specification for Design and Construction of Vessels and Tanks in Reinforced Plastics

The SudSceptor range features larger pipe connections, ideal for sites with higher peak flows, and offers easy integration with UK structural wall drainage systems.

INSTALLATION:

The installation design should consider traffic loadings, ground conditions and variable ground water elevations. If in any doubt consult your schemes' Designer/Engineer. A suitably qualified professional is required to sign off the installation.

www.sudsenvirono.com | sales@sudsenvirono.com | 01224057700

OPTIONAL POLISHING FILTER

The RHINOPOD polishing filter is engineered to capture a wide range of harmful substances, including oils, polycyclic aromatic hydrocarbons (PAHs), phosphorus, nitrogen, and phosphate (PO₄). It is capable of removing the 33 priority substances identified in the EU Water Framework Directive, as well as heavy metals such as cadmium, copper, zinc, nickel, lead, and mercury.

SudSceptor

HYDRODYNAMIC SEPARATOR

SEHDS750 - SEHDS3000 | DATA SHEET

OVERVIEW

SudSceptor is a hydrodynamic separator of proven and tested performance, sold as SEHDS750 to SEHDS3000. Designed for use within SuDS treatment trains, it gives certainty of water quality treatment and protects downstream controlled waters from sediment-bound pollutants, enabling enhanced amenity and biodiversity downstream.

Units are designed in accordance with the NJDEP protocol, best advice (NJDEP covers TSS only) and the British Water Code of Practice. A SudSceptor can be used on-line or off-line, with or without an external bypass unit.

PERFORMANCE & HYDRAULICS

SudSceptor removes sediment-bound contaminants and is made in a range of sizes to suit site flows and conditions. It removes over 50% of fine TSS (0 to 200 microns, median size 75 microns) at design flows and up to 99% of coarse solids of 0.1 to 0.4 mm.

MITIGATION INDICES	TSS	METALS	HYDROCARBONS
NJDEP*	0.5	-	-
SudSceptor	0.5	0.40	0.40

* NJDEP protocol, with best advice in part as NJDEP covers TSS only; British Water Code of Practice. Extrapolated values follow the British Water How to Guide: Applying the CIRIA SuDS Manual (C753), Simple Index Approach (version 7, section 4.3, 2021). The USA NJDEP has no regulatory role or authority in the UK and Ireland.

DESIGN COMPLIANCE

- NJDEP protocol 2015 and 2020
- DIBt
- British Water Code of Practice
- GRP models to BS 4994:1987, vessels and tanks in reinforced plastics

CHAMBER OPTIONS

SEHDS750 and SEHDS1000 units are made from BBA-certificated HDPE twinwall pipe. SEHDS1200, SEHDS1500, SEHDS1800, SEHDS2500 and SEHDS3000 are built in glass reinforced plastic (GRP). The range takes larger pipe connections, suiting sites with higher peak flows, and integrates easily with UK structured-wall drainage systems.

INSTALLATION

Installation design should consider traffic loading, ground conditions and variable groundwater levels. If in any doubt consult the scheme designer or engineer. A suitably qualified professional is required to sign off the installation.

www.sudsenvirono.com | sales@sudsenvirono.com | 01224 057 700

OPTIONAL POLISHING FILTER

RHINOPOD is designed to absorb a wide range of harmful substances: Oils and PAHs, Phosphorous, Nitrogen, phosphate (PO₄), the 33 prioritised substances in the EU directive as well as heavy metals, including Cadmium, Copper, Zinc, Nickel, Lead, Mercury...

TECHNICAL DATA

Overall Height:	3740mm
Chamber ID:	1800mm
Height to Invert:	1170mm
Height to inlet centre:	2570mm
Max Inlet/Outlet ID:	600mm
Sediment Storage Capacity:	1027 litres
Oil/Debris Storage Capacity:	1462 litres

Adobe Express, November 2023. One page.

Illustrator, June 2025. One page.

Web sheet, page 1 of 4. Covers SEHDS750 to SEHDS3000.

1200

2400

3600

4800

1

Suds Enviro
SudSceptor

HYDRODYNAMIC SEPARATOR

2

DATA SHEET SEHDS1800

3

OVERVIEW

The SudSceptor is a Hydrodynamic Separator with a unique design with a proven and tested performance. Designed for use within SUDS treatment trains, providing certainty of water quality treatment, enabling enhanced amenity and bio-diversity downstream. Protecting and defending downstream controlled waters from sediment bound pollutants.

Units within the SudSceptor Range have been designed in accordance with * NJDEP protocol, + "best advice" (in part as NJDEP only covers TSS), British Water Code of Practice. Please note that USA NJDEP has no regulatory role or authority in the UK and Ireland. It can be used on-line or off-line and with or without an external by-pass unit.

Multi treatment water purification processes are involved.

DESIGN CERTIFICATION & TESTING

- NJDEP 2015 & 2020
- DIBt.

PERFORMANCE

The SudSceptor removes sediment bound contaminants. Available in differing sizes to suit site flows and conditions. The SudSceptor removes over 50% of fine TSS (0-200 microns, median size 75 microns) at design flows and up to 99% of TDS 0.1 to 0.4mm (coarse).

MITIGATION INDICES	TSS	Total Metals	Total Hydrocarbons
NJDEP*	0.5	—	—
SUDSCEPTOR	0.5	0.40	0.50
British Water Code of Practice*	0.5	0.38	0.53

* NJDEP protocol, + "best advice" (in part as NJDEP only covers TSS), British Water Code of Practice

2

DATA SHEET SEHDS1800

FEATURES & BENEFITS

- Single Piece Unit
- Cannot air lock
- Wide variety of connection availabilities
- Inlet deflector Plate creates the cyclic process
- Floatable materials and liquids are retained
- Settled solids are prevented from remobilisation
- A uniformed flow pathway is ensured by a distributed upwards flow.
- Weir ensures optimised flow pathways
- Easy maintenance
- 10 year warranty

INNER VORTEX

OUTER VORTEX

OPTIONAL POLISHING FILTER

RHINOPOD is designed to absorb a wide range of harmful substances: Oils and PAH, Phosphorous, Nitrogen, phosphate (PO4), the 33 prioritised substances in the EU directive as well as heavy metals, including Cadmium, Copper, Zinc, Nickel, Lead, Mercury...

TECHNICAL DATA

4

Overall Height:	3740mm
Chamber ID:	1800mm
Height to Invert:	1170mm
Height to Inlet centre:	2570mm
Max Inlet/Outlet ID:	600mm
Sediment Storage Capacity:	1027 litres
Oil/Debris Storage Capacity:	1455 litres

CHAMBER OPTIONS

We recommend SudSceptor SEHDS750, SEHDS1000 units are manufactured within twinwall chambers. Models : SEHDS1200, SEHDS1500, SEHDS1800, SEHDS2500 are manufactured within Glass Reinforced Plastic (GRP) chambers. The SudSceptor range hydraulic flow rates have larger pipe connection sizes, ideal for sites where higher peak flows are anticipated or required. The SudSceptor series also afford ease of connection to the structural wall drainage pipes commonly used in the UK stormwater drainage market.

INSTALLATION:

The installation design should consider traffic loadings, ground conditions and variable ground water elevations. If in any doubt consult your schemes' Designer/Engineer. A suitably qualified professional is required to sign off the installation.

www.sudsenviro.com | Email: sales@sudsenviro.com | Sales & Technical support: Tel. 01224 057700

REDLINE / THE 2023 SHEET AS SUPPLIED

WHAT THE OLD SHEET WAS TELLING PEOPLE.

1

THE BRAND, WRITTEN TWO WAYS

“Suds Enviro” in the title, “SuDS Enviro” in the logo beside it.

2

A TITLE BAR PASTED TWICE

“DATA SHEET SEHDS1800” appears twice, both times as a low-resolution screenshot with JPEG blocking around the letters.

3

A DRAWING AT 222 × 349 PIXELS

The elevation is a small bitmap stretched to a third of the page. Dimensions blur when printed.

4

FIGURES WITH TYPOS IN THEM

“1027 litires” in the technical data. The 3740 mm overall height does not match the 4290 mm on the later sheets.

Shown untouched, as supplied. Redlines mark what a specifier would notice, not the engineering, which belongs to SuDS Enviro.

WHAT THE NEW SHEET DOES INSTEAD.

- 1

ONE MASTHEAD, ONE NAME
Product, family and code in a single set of type. SudSceptor, SEHDS750 to SEHDS3000.
- 2

DRAWN, NOT PASTED
Elevations redrawn in vector from SuDS Enviro’s own drawing packs, dimensioned in millimetres and marked not to scale.
- 3

TABLES YOU CAN READ
Mitigation indices set as a table, with the footnotes written out in full.
- 4

THE BLUE PANE, KEPT
Features and benefits stay in the blue pane SuDS customers already know.
- 5

PRINTS FROM THE WEBSITE
Each sheet is a page on the site that prints to four A4 pages, so the web and the PDF never drift apart.

SudSceptor

HYDRODYNAMIC SEPARATOR

SEHDS750 - SEHDS3000 | DATA SHEET

1

OVERVIEW

SudSceptor is a hydrodynamic separator of proven and tested performance, sold as SEHDS750 to SEHDS3000. Designed for use within SuDS treatment trains, it gives certainty of water quality treatment and protects downstream controlled waters from sediment-bound pollutants, enabling enhanced amenity and biodiversity downstream.

Units are designed in accordance with the NJDEP protocol, best advice (NJDEP covers TSS only) and the British Water Code of Practice. A SudSceptor can be used on-line or off-line, with or without an external bypass unit.

PERFORMANCE & HYDRAULICS

SudSceptor removes sediment-bound contaminants and is made in a range of sizes to suit site flows and conditions. It removes over 50% of fine TSS (0 to 200 microns, median size 75 microns) at design flows and up to 99% of coarse solids of 0.1 to 0.4 mm.

MITIGATION INDICES	TSS	METALS	HYDROCARBONS
NJDEP*	0.5	-	-
SudSceptor	0.5	0.40	0.40

* NJDEP protocol, with best advice in part as NJDEP covers TSS only; British Water Code of Practice. Extrapolated values follow the British Water How to Guide: Applying the CIRIA SuDS Manual (C753), Simple Index Approach (version 7, section 4.3, 2021). The USA NJDEP has no regulatory role or authority in the UK and Ireland.

DESIGN COMPLIANCE

- NJDEP protocol 2015 and 2020
- DIBt
- British Water Code of Practice
- GRP models to BS 4994:1987, vessels and tanks in reinforced plastics

CHAMBER OPTIONS

SEHDS750 and SEHDS1000 units are made from BBA-certificated HDPE twinwall pipe. SEHDS1200, SEHDS1500, SEHDS1800, SEHDS2500 and SEHDS3000 are built in glass reinforced plastic (GRP). The range takes larger pipe connections, suiting sites with higher peak flows, and integrates easily with UK structured-wall drainage systems.

INSTALLATION

Installation design should consider traffic loading, ground conditions and variable groundwater levels. If in any doubt consult the scheme designer or engineer. A suitably qualified professional is required to sign off the installation.

SuDS enviro

BESPOKE, STANDARDISED

2

SEHDS1800 elevation. Dimensions in mm.
NOT TO SCALE

FEATURES & BENEFITS

- Single-piece unit
- Cannot air lock
- Wide variety of connection options
- Inlet deflector plate promotes the cyclic process
- Floatable materials and liquids are retained
- Settled solids are prevented from remobilising
- Uniform flow path via distributed upward flow
- Weir ensures optimised flow paths
- Easy maintenance
- 10-year warranty

SPECIFICATION

Range	SEHDS750, 1200, 1800, 2500, 3000
Material	GRP from SEHDS1200; HDPE twinwall for SEHDS750
Treatment flow	32 to 259 L/s, by model
Connections	Up to Ø1200 mm inlet and outlet
Head loss	500 to 515 mm maximum
Filter	Optional RhinoPod polishing filter
Warranty	10 years

5

www.sudsenviron.com

sales@sudsenviron.com

01224 057 700


01 / 04

SUDS ENVIRO / REDRAWN


05

THE DRAWING, UP CLOSE


SAME UNIT. NEW LINE.

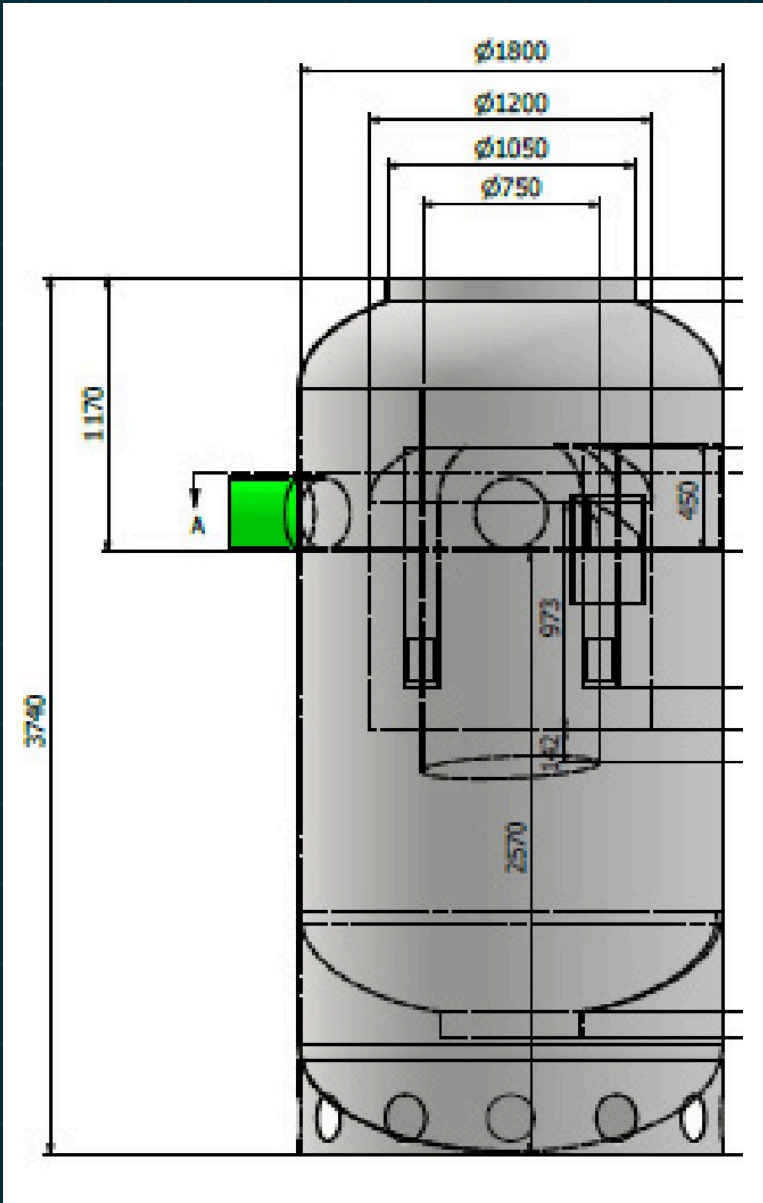


2023 / BITMAP, 222 × 349 PX

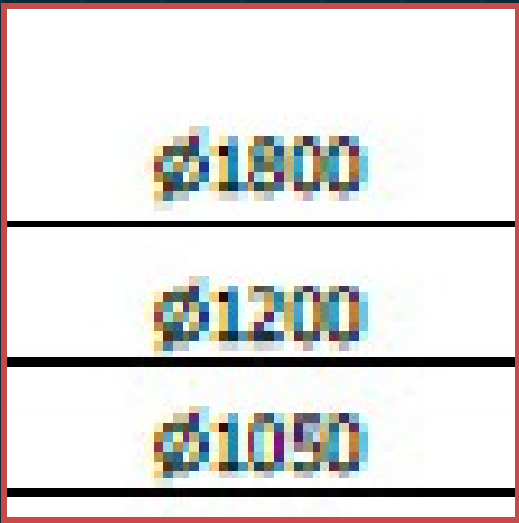

2023, enlarged. The bitmap breaks up before the numbers can be read.

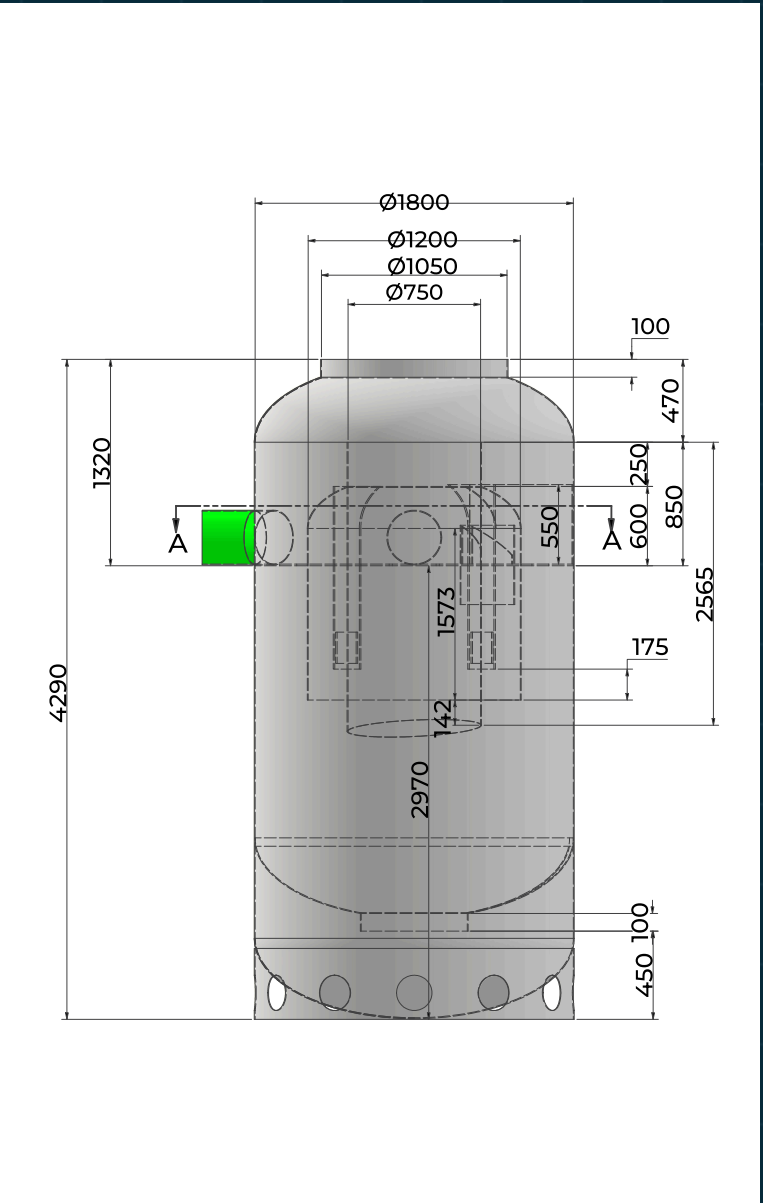

2026 / VECTOR, FROM THE DRAWING PACK

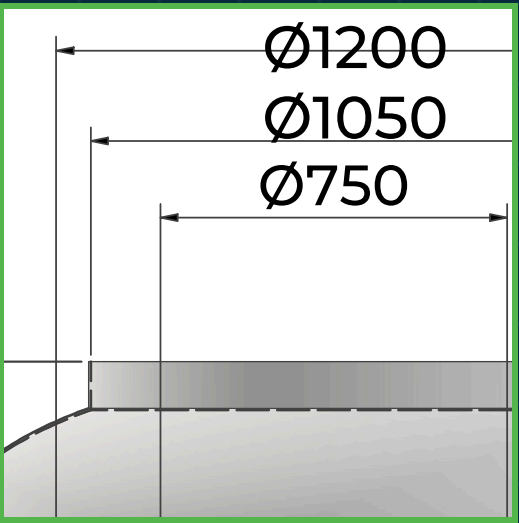

2026, enlarged. Vector, so it holds at any size.

REV A TO THE WHOLE RANGE.

2023

SUPPLIED

2025

FIRST PASS

2026

REDRAWN

Suds Enviro SudSceptor
HYDRODYNAMIC SEPARATOR
DATA SHEET: SEHDS1200

OVERVIEW
The SudSceptor is a Hydrodynamic Separator with a unique design with a proven and tested performance. Designed for use within SUDS treatment trains, providing certainty of water quality treatment, enabling enhanced amenity and bio-diversity downstream. Protecting and defending downstream controlled waters from sediment bound pollutants. Units within the SudSceptor Range have been designed in accordance with * NJDEP protocol, + "best advice" (in part as NJDEP only covers TSS), British Water Code of Practice. Please note that USA NJDEP has no regulatory role or authority in the UK and Ireland. It can be used on-line or off-line and with or without an external by-pass unit. Multi treatment water purification processes are involved.

DESIGN CERTIFICATION & TESTING

- NJDEP 2015 & 2020
- DIBt

PERFORMANCE
The SudSceptor removes sediment bound contaminants. Available in diff flows and conditions. The SudSceptor removes over 50% of fine TSS (0-20 75 microns) at design flows and up to 99% of TDS 0.1 to 0.4mm (coarse).

MITIGATION INDICES	TSS	Total Metals	Total Hydrocarbons
NJDEP*	0.5	---	---
SUDSCEPTOR	0.40	0.38	0.50
British Water Code of Practice*	0.5	0.38	0.53

* NJDEP protocol, + "best advice" (in part as NJDEP only covers TSS), British Water Code of Practice

FEATURES & BENEFITS

- Single Piece Unit
- Cannot air lock
- Wide variety of connection availabilities
- Inlet deflector Plate creates the cyclic process
- Floatable materials and liquids are retained
- Settled solids are prevented from remobilisation
- A uniformed flow pathway is ensured by a distributed upwards flow.
- Weir ensures optimised flow pathways
- Easy maintenance
- 10 year warranty

CHAMBER OPTIONS
We recommend SudSceptor SEHDS750, SEHDS1000 and SEHDS1200 units are manufactured within twinwall chambers. Models SEHDS1500, SEHDS1800, SEHDS2500 are manufactured within Glass Reinforced Plastic (GRP) chambers. The SudSceptor range hydraulic flow rates have larger pipe connection sizes, ideal for sites where higher peak flows are anticipated or required. The SudSceptor series also afford ease of connection to the structural wall drainage pipes commonly used in the UK stormwater drainage market.

INSTALLATION: The installation design should consider traffic loadings, ground conditions and variable ground water elevations. If in any doubt consult your schemes' Designer/Engineer. A suitably qualified professional is required to sign off the installation.

www.sudsenviro.com | Email: sales@sudsenviro.com | Sales & Technical support: Tel: 01224 057700

SuDS Enviro BESPOKE, STANDARDISED.

DATA SHEET: SEHDS1200

OPTIONAL POLISHING FILTER
RHINOPOD is designed to absorb a wide range of harmful substances: Oils and PAHs, Phosphorous, Nitrogen, phosphate (PO4), the 33 prioritised substances in the EU directive as well as heavy metals, including Cadmium, Copper, Zinc, Nickel, Lead, Mercury...

TECHNICAL DATA

Overall Height:	3455mm
Chamber ID:	1200mm
Height to Invert:	923mm
Height to inlet centre:	2100mm
Max Inlet/Outlet ID:	600mm
Sediment Storage Capacity:	415litres
Oil/Debris Storage Capacity:	370litres

SudSceptor
HYDRO-DYNAMIC SEPARATOR
SEHDS1200 | DATA SHEET

OVERVIEW
The SudSceptor is a Hydrodynamic Separator with a unique design with a proven and tested Performance. Designed for use within SUDS treatment trains, providing certainty of water quality treatment, enabling enhanced amenity and bio-diversity downstream. Protecting and defending downstream controlled waters from sediment bound pollutants. Units within the SudSceptor Range have been designed in accordance with * NJDEP protocol, + "best advice" (in part as NJDEP only covers TSS), British Water Code of Practice. Please note that USA NJDEP has no regulatory role or authority in the UK and Ireland. It can be used on-line or off-line and with or without an external by-pass unit. Multi treatment water purification processes are involved.

DESIGN COMPLIANCE

- NJDEP 2015 & 2020
- DIBt

PERFORMANCE & HYDRAULICS
The SudSceptor removes sediment bound contaminants. Available in differing sizes to suit site flows and conditions. The SudSceptor removes over 50% of fine TSS (0-200 microns, median size 75 microns) at design flows and up to 99% of TDS 0.1 to 0.4mm (coarse).

MITIGATION INDICES	TSS	METALS	HYDROCARBONS
NJDEP*	0.5	---	---
SUDSCEPTOR	0.5	0.40	0.40

* NJDEP protocol, + "best advice" (in part as NJDEP Only covers TSS), British Water Code of Practice

DIMENSIONAL & STORAGE DATA

- Treatment Flow Rate : 32 L/s
- Hydraulic Capacity Flow : 426 L/s
- Max Head Loss: 500mm

DIMENSIONAL & STORAGE DATA

- Overall Height: 2723 mm
- Chamber Diameter: 1200 mm
- Height to Invert Inlet: 1800 mm
- Base Height to Invert Outlet: 1914 mm
- Max Inlet/Outlet Diameter: 600 mm
- Sediment Storage Capacity: 415 litres
- Oil/Debris Storage Capacity: 370 litres

Extrapolated values are based on the guidelines outlined in the British Water 'How to Guide: Applying the CIRIA The SuDS Manual (C753)' utilizing the Simple Index Approach (Version 7, Section 4.3, 2021 - pre-publication)."

CHAMBER OPTIONS:
SudSceptor SEHDS750 and SEHDS1000 units are manufactured from BBA CERTIFICATED HIGH DENSITY POLYETHYLENE TWINWALL PIPE. Models SEHDS1200, SEHDS1500, SEHDS1800, SEHDS2500 & SEHDS3000 are built using Glass Reinforced Plastic (GRP) and comply fully with BS 4994:1987 - Specification for Design and Construction of Vessels and Tanks in Reinforced Plastics. The SudSceptor range features larger pipe connections, ideal for sites with higher peak flows, and offers easy integration with UK structural wall drainage systems.

INSTALLATION:
The installation design should consider traffic loadings, ground conditions and variable ground water elevations. If in any doubt consult your schemes' Designer/Engineer. A suitably qualified professional is required to sign off the installation.

www.sudsenviro.com | sales@sudsenviro.com | 01224057700

SuDS enviro RHINO

OPTIONAL POLISHING FILTER
The RHINOPOD polishing filter is engineered to capture a wide range of harmful substances, including oils, polycyclic aromatic hydrocarbons (PAHs), phosphorus, nitrogen, and phosphate (PO4). It is capable of removing the 33 priority substances identified in the EU Water Framework Directive, as well as heavy metals such as cadmium, copper, zinc, nickel, lead, and mercury.

SudSceptor
SIZE RANGE - SEHDS750 TO SEHDS3000

SuDS enviro BESPOKE, STANDARDISED.

SEHDS1800 - Ø1800, 4290 mm high
SEHDS2500 - Ø2500, 5290 mm high
SEHDS3000 - Ø3000, 5419 mm high

NOT TO SCALE Elevations are shown at different scales so each fits the column. The GRP models share one internal arrangement, scaled to each diameter.

CODE	CHAMBER	OVERALL HEIGHT	INLET INVERT FROM TOP	OUTLET INVERT FROM BASE	MAX PIPE	SEDIMENT STORAGE	OIL / DEBRIS STORAGE	TREATMENT FLOW	HYDRAULIC CAPACITY
SEHDS750	Ø750 HDPE								Performance and storage data on request
SEHDS1200	Ø1200 GRP	2723 mm	TBC	1914 mm	Ø600	415 L	370 L	32 L/s	426 L/s
SEHDS1800	Ø1800 GRP	4290 mm	1320 mm	2970 mm	Ø600	1027 L	1462 L	73 L/s	222 L/s
SEHDS2500	Ø2500 GRP	5290 mm	1620 mm	3670 mm	Ø1200	3594 L	2332 L	259 L/s	426 L/s
SEHDS3000	Ø3000 GRP	5419 mm	2000 mm	3419 mm	Ø1050	4779 L	5024 L	189 L/s	655 L/s

Figures from the SEHDS1200, SEHDS1800, SEHDS2500 and SEHDS3000 data sheets. Overall height and inlet invert on the SEHDS2500 are standard and can vary. Maximum head loss is 500 mm (515 mm on the SEHDS2500).

INSTALLATION

- Bed and surround to suit the traffic loading and ground conditions
- Allow for variable groundwater levels and flotation
- Set inlet and outlet to the design inverts
- Use on-line or off-line, with or without an external bypass
- Have the installation signed off by a suitably qualified professional

COMPLIANCE

- NJDEP protocol 2015 and 2020
- DIBt
- British Water Code of Practice
- CIRIA C753 Simple Index Approach
- GRP to BS 4994:1987

SPECIFY SUDSCEPTOR
Send us the treatment flow, pipe sizes and invert levels and our team will select the model for your site.

COMPANY	SuDS Enviro
SALES	sales@sudsenviro.com
TELEPHONE	01224 057 700
WEB	www.sudsenviro.com

www.sudsenviro.com | sales@sudsenviro.com | 01224 057 700

04 / 04

Rev A, Adobe Express, November 2023. "415itires" in the storage data.

Illustrator, July 2025. One sheet per size.

Page 4 of the range sheet. Every size side by side in one table.

SudSceptor

HYDRO-DYNAMIC SEPARATOR
SEHDS1800 | DATA SHEET



OVERVIEW

The SudSceptor is a Hydrodynamic Separator with a unique design with a proven and tested Performance. Designed for use within SuDS treatment trains, providing certainty of water quality treatment, enabling enhanced amenity and bio-diversity downstream. Protecting and defending downstream controlled waters from sediment bound pollutants.

Units within the SudSceptor Range have been designed in accordance with * NJDEP protocol, + "best advice" (in part as NJDEP only covers TSS), British Water Code of Practice .

Please note that USA NJDEP has no regulatory role or authority in the UK and Ireland. It can be used on-line or off-line and with or without an external by-pass unit. Multi treatment water purification processes are involved.

DESIGN COMPLIANCE

- NUDEP 2015 & 2020
- DfBL

PERFORMANCE & HYDRAULICS

The SudSceptor removes sediment bound contaminants. Available in differing sizes to suit site flows and conditions. The SudSceptor removes over 50% of fine TSS (0-200 microns, median size 75 microns) at design flows and up to 99% of TDS 0.1 to 0.4mm (coarse).

MITIGATION INDICES	TSS	METALS	HYDROCARBONS
NJDEP*	0.5	---	---
SUDSCEPTOR	0.5	0.40	0.40



* NJDEP protocol, + "best advice" (in part as NJDEP Only covers TSS), British Water Code of Practice

DIMENSIONAL & STORAGE DATA

- Treatment Flow Rate : 73 L/s
- Hydraulic Capacity Flow : 222 L/s
- Max Head Loss: 500mm

DIMENSIONAL & STORAGE DATA

- Overall Height: 4290 mm
- Chamber Diameter: 1800 mm
- Height to Invert Inlet: 1320 mm
- Base Height to Invert Outlet: 2970 mm
- Max Inlet/Outlet Diameter: 600 mm
- Sediment Storage Capacity: 1027 litres
- Oil/Debris Storage Capacity: 1462 litres

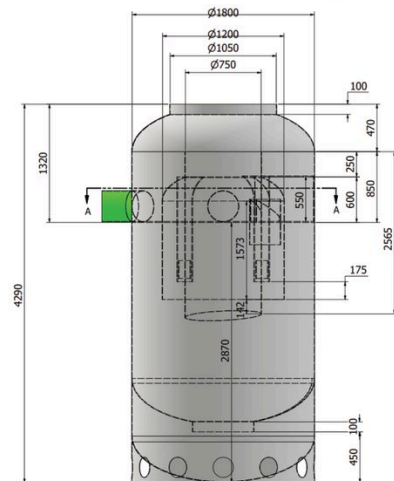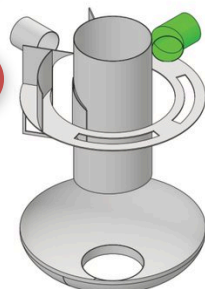

FEATURES & BENEFITS

- Single-piece unit
- Cannot air lock
- Wide variety of connection options available
- Inlet deflector plate promotes cyclic process
- Floatable materials and liquids are retained
- Settled solids are prevented from remobilisation
- Uniform flow pathway via distributed upwards flow
- Weir ensures optimised flow pathways
- Easy maintenance
- 10-year warranty

Extrapolated values are based on the guidelines outlined in the British Water 'How to Guide: Applying the CIRA The SuDS Manual (C753)' utilizing the Simple Index Approach (Version 7, Section 4.3, 2021 - pre-publication)."

CHAMBER OPTIONS:

SudSceptor SEHDS750 and SEHDS1000 units are manufactured from BBA CERTIFICATED HIGH DENSITY POLYETHYLENE TWINWALL PIPE. Models SEHDS1200, SEHDS1500, SEHDS1800, SEHDS2500 & SEHDS300 are built using Glass Reinforced Plastic (GRP) and comply fully with BS 4994:1987 - Specification for Design and Construction of Vessels and Tanks in Reinforced Plastics

The SudSceptor range features larger pipe connections, ideal for sites with higher peak flows, and offers easy integration with UK structural wall drainage systems.

INSTALLATION:

The installation design should consider traffic loadings, ground conditions and variable ground water elevations. If in any doubt consult your schemes' Designer/Engineer. A suitably qualified professional is required to sign off the installation.

OPTIONAL POLISHING FILTER



The RHINOPOD polishing filter is engineered to capture a wide range of harmful substances, including oils, polycyclic aromatic hydrocarbons (PAHs), phosphorus, nitrogen, and phosphate (PO₄). It is capable of removing the 33 priority substances identified in the EU Water Framework Directive, as well as heavy metals such as cadmium, copper, zinc, nickel, lead, and mercury.

REDLINE / THE 2025 FIRST PASS

THE STEP BETWEEN, CHECKED THE SAME WAY.

1

NUDEP FOR NJDEP

The compliance line reads "NUDEP 2015 & 2020". The 2026 sheet spells it correctly.

2

ONE HEADING, USED TWICE

"Dimensional & storage data" heads both blocks, though one of them holds flow rates and head loss.

1

WHAT IT GOT RIGHT

One masthead with the RHINO lockup, the blue features pane, and typeset tables. The 2026 sheets kept all three.



| www.sudsenviron.com




| sales@sudsenviron.com



| 01224057700


FROM DRAWING PACK TO DATA SHEET.

2022 / INVENTOR

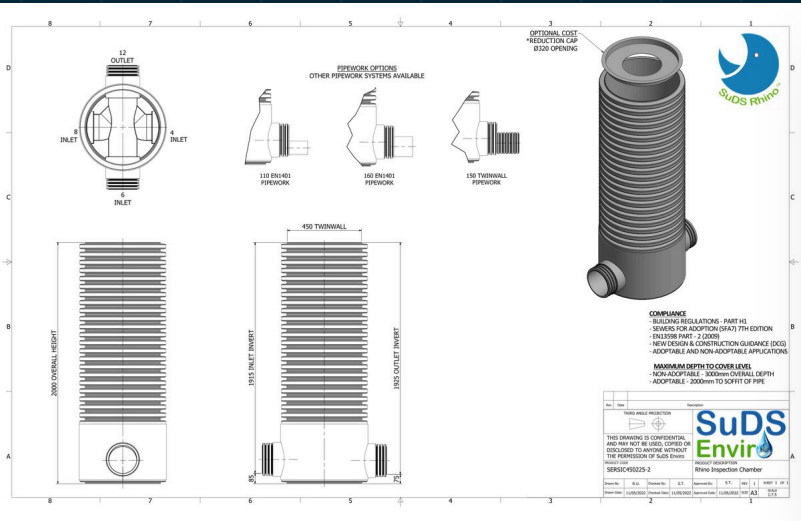


SERSIC450, drawing pack sheet. A3, third angle.

2021 / AUTOCAD

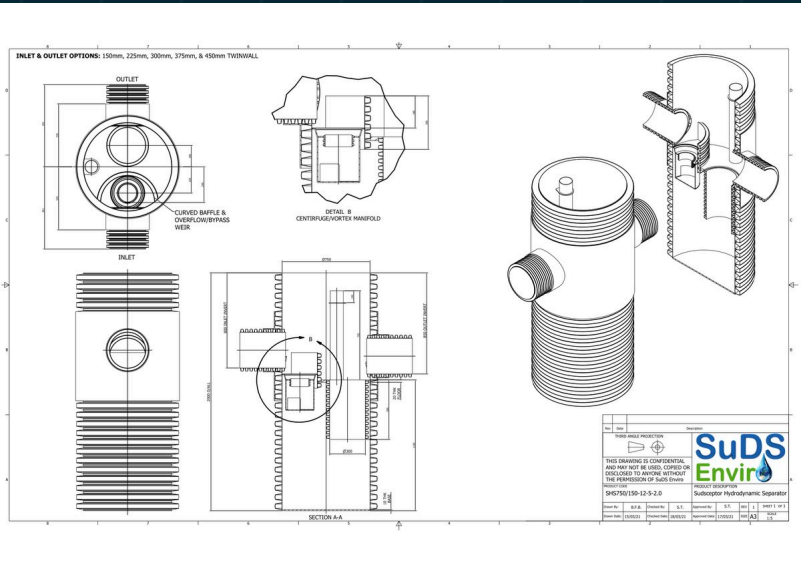


SEHDS750 general arrangement, March 2021.

2023 / INVENTOR

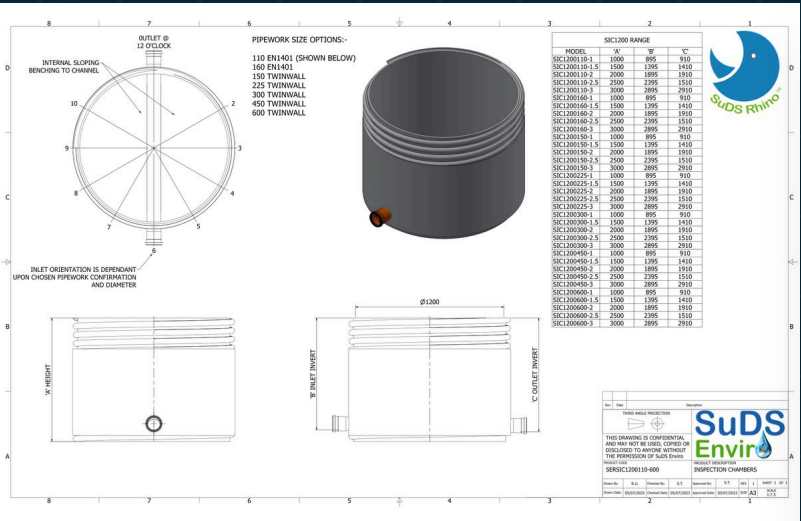


SERSIC1200 range. 35 model codes in one table.

2026

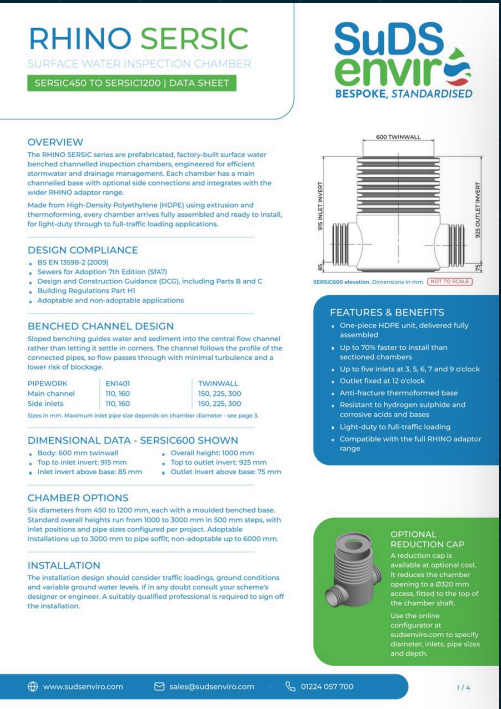

RHINO SERSIC, 2026, pages 1 and 2: the plan with the clock face, elevations and pipework options from the same drawing pack.

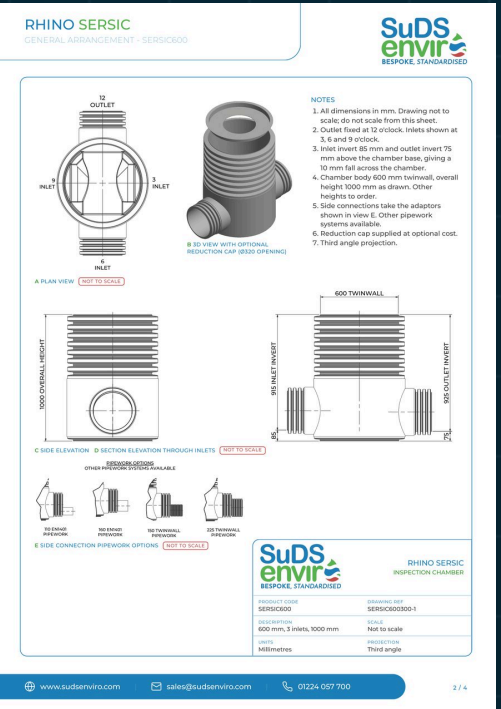


THE 2026 SET

14 SHEETS. ONE SYSTEM.

Chambers, catchpits, flow control, separators, pumping, drawpits, grease and septic. Same masthead, same grid, same drawing standard, same footer.

Each is a page on the website at /brochures, printed here exactly as the site prints it.

SEVEN CHOICES IN. A DRAWN SHEET OUT.

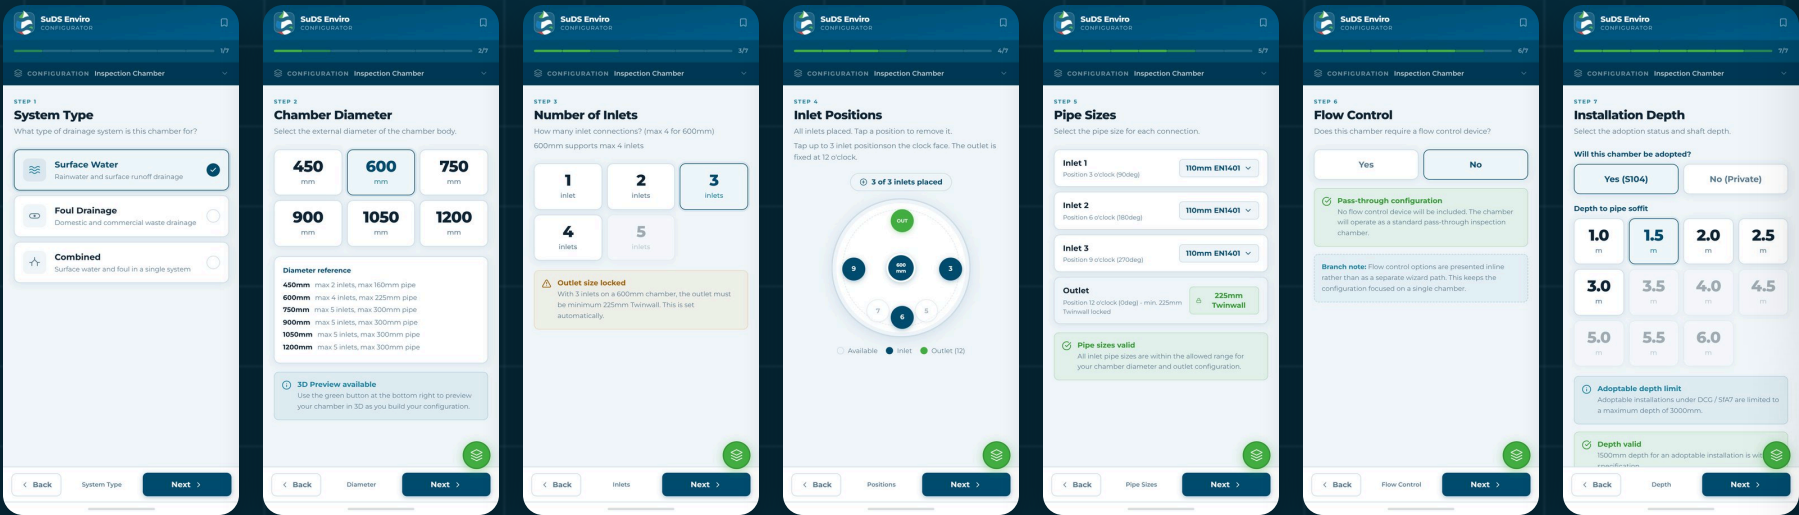

System, diameter, inlets, clock positions, pipe sizes, flow control, depth. Each step is checked against the seven rules (R1 to R7) before the next opens.

The configurator turns those answers into a two-page technical specification: project information, the rule check, pipework schedule, a plan and section drawn to the chosen sizes, and a bill of materials. No two are the same; this one is a SERSIC1050, 3000 mm deep, five inlets.

SE

SuDS Enviro Ltd

The Home of SuDS Rhino

TECHNICAL SPECIFICATION

INSPECTION CHAMBER

RHINO SERSIC SERIES

PRODUCT CODE

SERSIC1050-3000-S104

DATE

23 Sep 2026

SIZE

Ø1050 x 3000 mm

SHEET

1 of 2

PROJECT INFORMATION

Configuration ref3P9C2A71

Quote refNot yet quoted

Date issued23 Sep 2026

Drawing noSE-DRG-SERSIC1050-3000-S104

ProductInspection chamber

SeriesRHINO SERSIC SERIES

StatusPASSRule checks passed

CHAMBER SPECIFICATION

SystemSurface water

External diameter1050 mm

Depth to outlet soffit3000 mm

Overall height3615 mm

Sump below outlet invert350 mm

AdoptionS104 adoptable

Maximum depth3000 mm (S104)

AccessReducing cap, Ø600 clear opening

CoverD400 cover and frame

MaterialHDPE, BS EN 13398-2

COMPLIANCE

STANDARD	SCOPE	STATUS
DCG Section C7.11	Sediment Management - Adoptable	PASS
Sewers for Adoption 7th Ed. (SfA7)	Adoptable Sewer Standards	PASS
BS EN 13398-2 (2009)	Plastic Inspection Chambers	PASS
Building Regulations Part H1	Surface Water Drainage	PASS
DCG Parts B and C	Minimum 50mm fall from side inlets to main channel	PASS
DCG Restricted Access (350mm > 1m depth)	Manhole Cover Compliance	PASS
Outlet rule - no flow increase on exit	Rule Engine Validation	PASS

PIPEWORK

REF	POSITION	ANGLE	SIZE	INVERT H	CENTRE H
OUT	12 o'clock	0°	Ø225 Twinwall	350	463
IN1	3 o'clock	90°	Ø225 Twinwall	350	463
IN2	5 o'clock	150°	Ø160 EN1401	424	500
IN3	6 o'clock	180°	Ø160 EN1401	424	500
IN4	7 o'clock	210°	Ø110 EN1401	471	523
IN5	9 o'clock	270°	Ø160 EN1401	424	500

Heights in mm above the internal base. Outlet fixed at 12 o'clock (0°), north; angles clockwise from north. Inlet soffits aligned with the outlet soffit. No flow control selected.

RULE ENGINE LOG

RULE	CHECK	RESULT	STATUS
R1	Maximum inlets	5 of 5 inlets allowed for a 1050mm chamber.	PASS
R2	Outlet minimum size	5 inlets need at least a Ø225 twinwall outlet. Outlet locked at Ø225 TW.	PASS
R3	Blocked positions	None. The outlet at 12 o'clock does not block any inlet position.	PASS
R4	Maximum depth	3000mm selected, 3000mm maximum (S104 adoptable).	PASS
R5	Outlet position	Outlet fixed at 12 o'clock (0°). Inlets at 3, 5, 6, 7, 9 o'clock.	PASS
R6	No flow increase on exit	No inlet is larger than the Ø225 TW outlet.	PASS
R7	Maximum pipe size	All pipes within the Ø300 maximum for a 1050mm chamber.	PASS

Generated by the SuDS Enviro configurator. Subject to technical review by SuDS Enviro before manufacture. Engineering drawing on sheet 2.

SuDS Enviro Ltd | 9 Ambleside Court, Chester-le-Street DH3 2EB | 01224 057 700 | sales@sudsenvirono.com

PLAN VIEW (COVER REMOVED) | SCALE 1:20

SECTION A-A LOOKING WEST | SCALE 1:20 | SHAFT SHOWN BROKEN

BILL OF MATERIALS

#	DESCRIPTION	MATERIAL	QTY	PART NO.
1	Chamber body and base	HDPE, BS EN 13398-2	1	SE-SERSIC1050-BODY
2	Riser shaft sections	HDPE	A/R	SE-SERSIC1050-RISER
3	Reducing cap to Ø600 opening	HDPE	1	SE-CA1050-Ø600
4	D400 cover and frame	Ductile Iron, BS EN 124	1	SE-COVER-D400
5	Pipe sealing rings	EPDM, BS EN 681-1	6	SE-SEAL-EPDM
6	Access steps	GRP, BS EN 1301	Set	SE-STEP-GRP

GENERAL NOTES

- ALL DIMENSIONS IN MILLIMETRES UNLESS STATED. DO NOT SCALE FROM THIS DRAWING.
- OUTLET FIXED AT 12 O'CLOCK (0°), NORTH. INLET ANGLES ARE MEASURED CLOCKWISE FROM NORTH. INLETS ARE MANUFACTURED AT 3, 5, 6, 7 AND 9 O'CLOCK ONLY.
- OUTLET SIZE Ø225 TWINWALL IS RULE ENGINE LOCKED (R2.5 INLETS) DO NOT REDUCE.
- INLET SOFFITS ARE ALIGNED WITH THE OUTLET SOFFIT. IN THE PIPE CENTRELINE HEIGHT ABOVE THE INTERNAL BASE.
- SUMP DEPTH 350mm IS MEASURED FROM THE OUTLET INVERT TO THE INTERNAL BASE.
- DEPTH IS MEASURED FROM COVER LEVEL TO THE OUTLET SOFFIT. MAXIMUM 3000mm S104 ADAPTABLE, 6000mm PRIVATE.
- PIPE JOINT SEALS TO BS EN 681-1. LUBRICATE TO THE MANUFACTURER'S SPECIFICATION.
- TOLERANCES: LINEAR +1.5mm, ANGULAR +1°; THIRD ANGLE PROJECTION.

SE

SuDS Enviro Ltd

The Home of SuDS Rhino

INSPECTION CHAMBER

RHINO SERSIC SERIES

Ø1050mm x 3000mm to outlet soffit | HDPE, BS EN 13398-2

Surface water | S104 adoptable | 5 inlets

CODE SERSIC1050-3000-S104

DRG NO.

SE-DRG-SERSIC1050-3000-S104

DATE

23 Sep 2026

SHEET

2 of 2

REVISION

A

SCALE (A4)

PLAN 1:20

SECTION 1:20

PROJECTION

THIRD ANGLE

DRAWN BY

Configurator

CHECKED

Review required

APPROVED

Pending

BEFORE ANYTHING ELSE IS PRINTED

FIGURES THAT MOVED BETWEEN EDITIONS.

MODEL	FIGURE	2023	2025	2026
SEHDS1800	Overall height	3740 mm	4290 mm	4290 mm
SEHDS1800	Inlet invert from top	1170 mm	1320 mm	1320 mm
SEHDS1800	Oil / debris storage	1455 L	1462 L	1462 L
SEHDS1200	Overall height	3455 mm	2723 mm	2723 mm
SEHDS1200	Inlet invert	923 mm	1800 mm	TBC
SEHDS1200	Sediment storage	415 L	415 L	415 L

The redraw copied figures across; it did not invent them. Where the 2023 sheets and the drawing packs disagree, the 2026 sheet carries the 2025 figures, and where no source settles it, it says **TBC** rather than guess.

These are SuDS Enviro's numbers to confirm. One sign-off against the current drawing packs closes every line.

WHAT CHANGED

- Every drawing, redrawn in vector
- One template across 14 sheets
- One spelling of the brand and the range
- Sheets live on the website and print to A4
- Project sheets written by the configurator

WHAT STAYED

- Product codes and model names
- The features and benefits
- The compliance claims and their footnotes
- The blue pane and the SuDS Enviro voice
- SuDS Enviro's engineering

EVERY DROP, ACCOUNTED FOR.